

Date: Wednesday, 1/18/2006 4:06:35 PM
 User: Kim Johnston

Process Sheet

Customer : CU-DAR001 Dart Helicopters Services	Drawing Name : BEARING ASSEMBLY
Job Number : 25561	
Estimate Number : 10716	
P.O. Number : N/A	Part Number : D3121241
This Issue : 1/18/2006 S.O. No. : N/A	Drawing Number : D3121 REV C2
Prsht Rev. : NC	Project Number : N/A
First Issue : N/A Type : MACHINED PARTS	Drawing Revision : C2
Previous Run : 25477	Material : N/A
	Due Date : 2/5/2006
Written By : <u>SEE COMMENT BELOW</u>	Qty: <u>40</u> Um: Each
Checked & Approved By : <u>SEE ABOVE DATE & USER</u>	
Comment : Est Rev:A 04.02.18 New issue KJ/DS	

Additional Product

Job Number:



Seq. #:	Machine Or Operation:	Description :
1.0	MDELINR12500	DELIN ROUND BAR 1.25"
Comment: Qty.: 0.0431 f(s)/Unit Total : 1.7220 f(s) Material: Ø1.25 Delrin Rod <u>M16128 30"</u> (M-DELIN-R1.2500) Identify as D3121-25 Batch: <u>M100010 5"</u> <u>.052</u>		
2.0	HARDINGE	HARDINGE CNC LATHE SMALL
Comment: HARDINGE CNC LATHE SMALL 1-Turn D3121-25 Cap as per Folio FA387 2-Deburr <u>BG 06.02.12 40</u>		
3.0	QC2	INSPECT PARTS AS THEY COME OFF MACHINE
Comment: INSPECT PARTS AS THEY COME OFF MACHINE <u>BG 06.02.12 40</u>		
4.0	QC8	SECOND CHECK
Comment: SECOND CHECK <u>S.G. 06/02/12 40</u>		
5.0	D312123	Bearing
Comment: Qty.: 1.0000 Each(s)/Unit Total : 40.0000 Each(s) Pick: <u>7 B25878</u> Qty Part Number Description Batch 1 D3121-23 Bearing <u>B25432</u> <u>X31</u> <u>BG 06.02.12</u>		

Dart Aerospace Ltd

W/O:		WORK ORDER CHANGES					
DATE	STEP	PROCEDURE CHANGE	By	Date	Qty	Approval Chief Eng / Prod Mgr	Approval QC Inspector

Part No: _____ PAR #: _____ Fault Category: _____ NCR: Yes ☒ No ☐ DQA: LD Date: 06/02/22
 QA: N/C Closed: _____ Date: _____

NCR:		WORK ORDER NON-CONFORMANCE (NCR)						
DATE	STEP	Description of NC Section A	Corrective Action Section B			Verification Section C	Approval Chief Eng	Approval QC Inspector
			Initial Chief Eng	Action Description Chief Eng	Sign & Date			

NOTE: Date & initial all entries

Date: Wednesday, 1/18/2006 4:06:35 PM
User: Kim Johnston

Process Sheet

Customer: CU-DAR001 Dart Helicopters Services

Drawing Name: BEARING ASSEMBLY

Job Number: 25561

Part Number: D3121241

Job Number:



Seq. #:

Machine Or Operation:

Description :

6.0

SMALL FAB 1

SMALL & MEDIUM FAB RESOURCE 1



Comment: SMALL & MEDIUM FAB RESOURCE 1

SB 06/02/20

(7)

1-Press D3121-23 Bearing into D3121-25 Cap as per Dwg D3121

BG 06-02-12

31 + 9 u/o

7.0

QC5

INSPECT WORK TO CURRENT STEP



Comment: INSPECT WORK TO CURRENT STEP

BG 06-02-12

31 + 9

Bearings
(41)

8.0

PACKAGING 1

PACKAGING RESOURCE #1



Comment: PACKAGING RESOURCE #1

Identify and Stock

Location: _____

st 409

06/2/21 (41)

9.0

DC

DOCUMENT CONTROL



Comment: DOCUMENT CONTROL

Inspection Level 21

505 06/02/22

(41)

(41)
P. 06/02/22

Job Completion



W/O:		WORK ORDER CHANGES					
DATE	STEP	PROCEDURE CHANGE	By	Date	Qty	Approval Chief Eng / Prod Mgr	Approval QC Inspector

Part No: _____ PAR #: _____ Fault Category: _____ NCR: Yes No DQA: _____ Date: _____

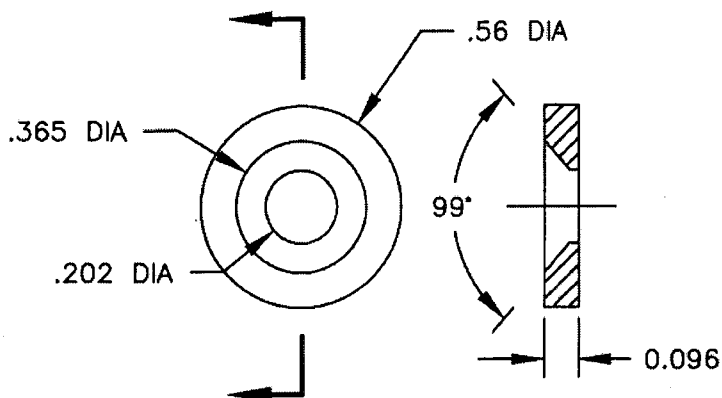
QA: N/C Closed: _____ Date: _____

NCR:		WORK ORDER NON-CONFORMANCE (NCR)						
DATE	STEP	Description of NC Section A	Corrective Action Section B			Verification Section C	Approval Chief Eng	Approval QC Inspector
			Initial Chief Eng	Action Description Chief Eng	Sign & Date			

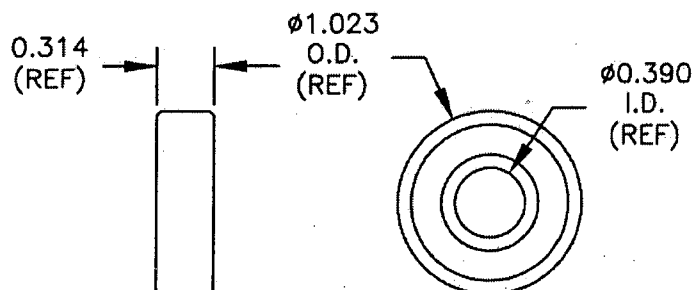
NOTE: Date & initial all entries

DART

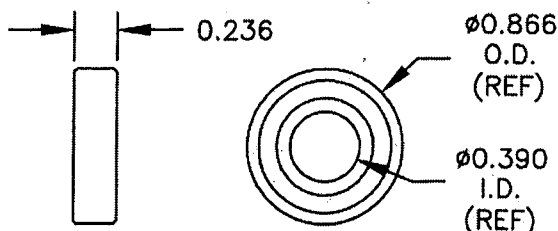
DESIGN <i>[Signature]</i>	DRAWN BY <i>[Signature]</i>	DART AEROSPACE LTD HAWKESBURY, ONTARIO, CANADA	
CHECKED <i>[Signature]</i>	APPROVED <i>[Signature]</i>	DRAWING NO. D3121	REV. C SHEET 10 OF 10

**D3121-17 WASHER (SCALE 2:1)**

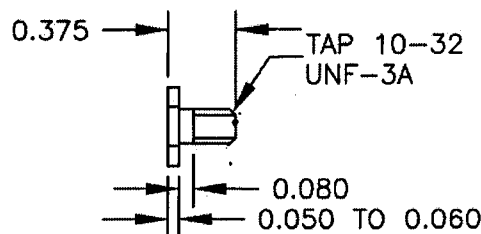
- 1) REPLACES PREMIER P/N B32-23001-17
- 2) MATERIAL: AISI 303 SS ROUND BAR, ANNEALED (REF DART SPEC. M303R)
- 3) TOLERANCES ARE PER DART QSI 018 UNLESS OTHERWISE NOTED
- 4) ALL DIMENSIONS ARE IN INCHES
- 5) BREAK ALL SHARP EDGES 0.005 TO 0.015

**D3121-19 BEARING (SCALE 1:1)**

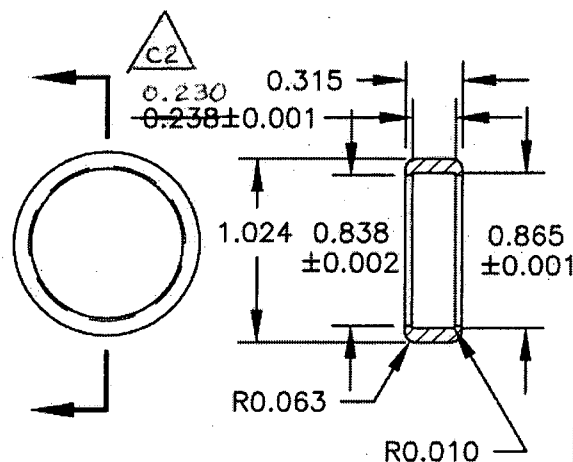
- 1) POSSIBLE SUPPLIER: KING BEARING P/N 6000-2ZJ/EM FAFNIR P/N 9100KDD
- 2) ALL DIMENSIONS ARE IN INCHES

**D3121-23 BEARING (SCALE 1:1)**

- 1) POSSIBLE SUPPLIER: SKF P/N 61900-2Z OR KML P/N 6900-2Z
- 2) ALL DIMENSIONS ARE IN INCHES

**D3121-21 BOLT (SCALE 1:1)**

- 1) MATERIAL: AISI 303 SS HEX, ANNEALED (REF DART SPEC. M303H0.500)
- 2) FINISH: NONE
- 3) TOLERANCES ARE PER DART QSI 018 UNLESS OTHERWISE NOTED
- 4) ALL DIMENSIONS ARE IN INCHES
- 5) BREAK ALL SHARP EDGES 0.005 TO 0.015

**D3121-25 CAP (SCALE 1:1)**

- 1) MATERIAL: DELRIN ROD, Ø1.25 (REF DART SPEC. M-DELIN-R1.250)
- 2) TOLERANCES ARE PER DART QSI 018 UNLESS OTHERWISE NOTED
- 3) ALL DIMENSIONS ARE IN INCHES

RELEASED
04.03.01

**D3121-241 BEARING ASSEMBLY (SCALE 1:1)**

Copyright © 2002 by DART AEROSPACE LTD

THIS DOCUMENT IS PRIVATE AND CONFIDENTIAL AND IS SUPPLIED ON THE EXPRESS CONDITION THAT IT IS NOT TO BE USED FOR ANY PURPOSE OR COPIED OR COMMUNICATED TO ANY OTHER PERSON WITHOUT WRITTEN PERMISSION FROM DART AEROSPACE LTD.

WORK ORDER
NO. 25561